PRODUCT DW[illegible]-2263 ~~F.R. 37~~	UNION METALLIC CARTRIDGE CO. BRIDGEPORT CONN.	ADDITIO[illegible]L PRODUCTS	CHANGES ~~36~~
PRODUCT 22 AUTOMATIC RIFLE WIN. MOD. 03 KBR		22-45 AUTO. RIFLE WIN. 03 KBR. HOL. PT.	3 ADDED GROOVE. 4 ADDED NOTE RELATIVE TO HOL. PT. BULLET.
DRAWING OF R.F. CARTRIDGE		PETERS: .22 WIN. AUTO. RUSTLESS (CAT. #2237)	5 ADDED BULLET GROOVE DIMENSIONS.
SCALE 4 ins. = 1 in.	ISSUED		6 .315 .305 WAS .313 .308 .0605 .0545 WAS .060 .055
DRAWN C.H.S. TRACED 8-23-12	H.J.S. CHECKED 8-29-12 C.H.S.		7 .2265 .226 WAS .227 .2265 8 HOL. PT. BULLET WHICH WAS NOT KNURLED GROOVED ON
APPROVED 8-30-12 C. F. Lindsay	APPROVED 9-3-12 J.O. Hoagland		NOSE OF BULLET WILL NOW BE GROOVED. 9 .390 .380 WAS .380 .370
APPROVED 9-3-12 Will Thomas	APPROVED 9-6-12 C. C. Tyler		10 F.R. No. CHANGED 11 PETERS PRODUCT ADDED 8/28/36 EH 12 .057 .050 WAS .0605 .0545

3	9/26/1919 C.H.S.	4	2-3-22 C.H.S.	5	5-17-22 C.H.S.	6	10-13-22 C.H.S.	7	10-6-26 EGW
8	6-27-27 EGW	9	3-20-30 EGW	10	6-6-33 EH	11	8/28/36 EH	12	4/15/38 EH

JUL 28 1949

~~Nominal Powder Charge~~

~~22 Auto. Rifle, Win. Mod. 03 - 1.5 Grs, Dupont No 93~~

~~" " " " " Hol. Pt. - 1.5 " " " "~~

Components

Shell ~~F.R. 39~~ S-2263

Bullet, ~~F.R. 38~~ B-2263
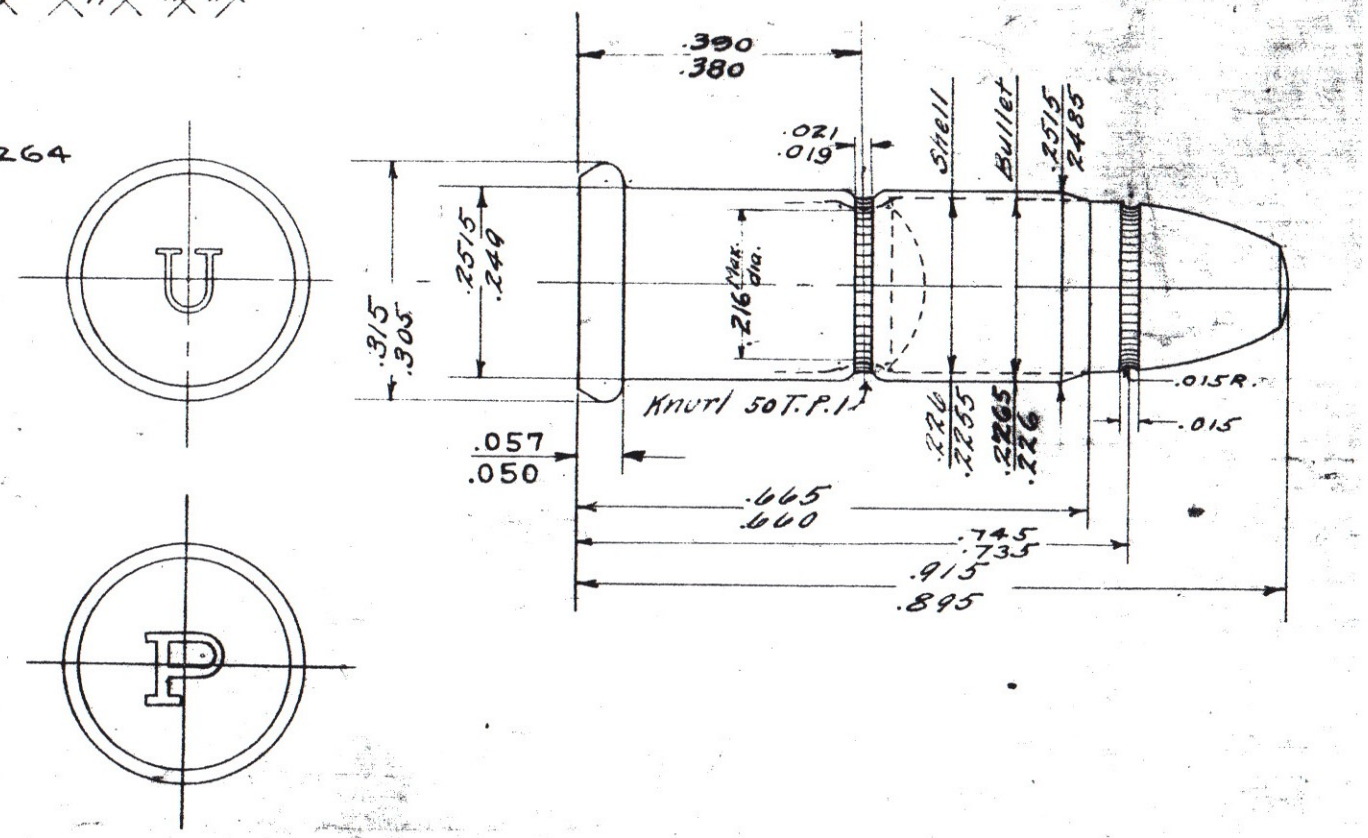
Bullet, Hol. Pt. ~~F.R. 69~~ B-2264